
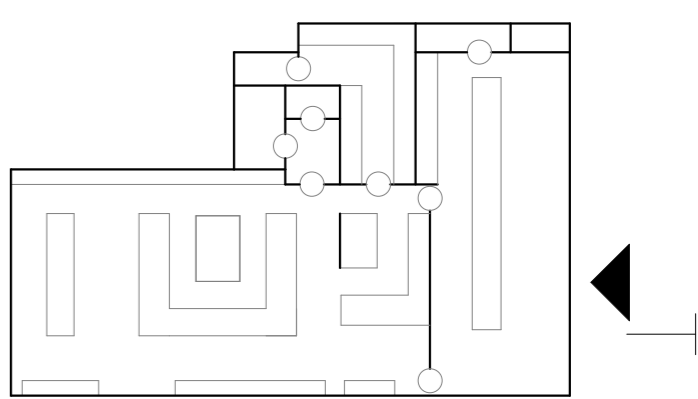


All dimensions are to be checked onsite prior to commencement of works. The Client to be notified of any discrepancies. Do not scale from this drawing.

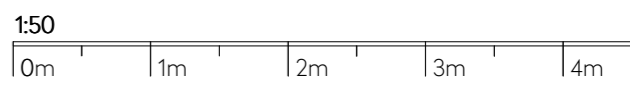

Rev	Note	Dr/Ch/App	Date

T A Y

Project

**ALEX KRATENA
TAYER + ELEMENTARY**

UNIT 1
152 OLD STREET
LONDON
EC1V 9BW


Drawing Information

EXTERNAL ELEVATION


Status:	AS BUILT	Drawn:	KRA
Scale:	150 @A2	Checked:	AK
First issue:	02/26/20	Approved:	AK

Drawing Number Revision


TAY-ZZ-00-DR-A-6601

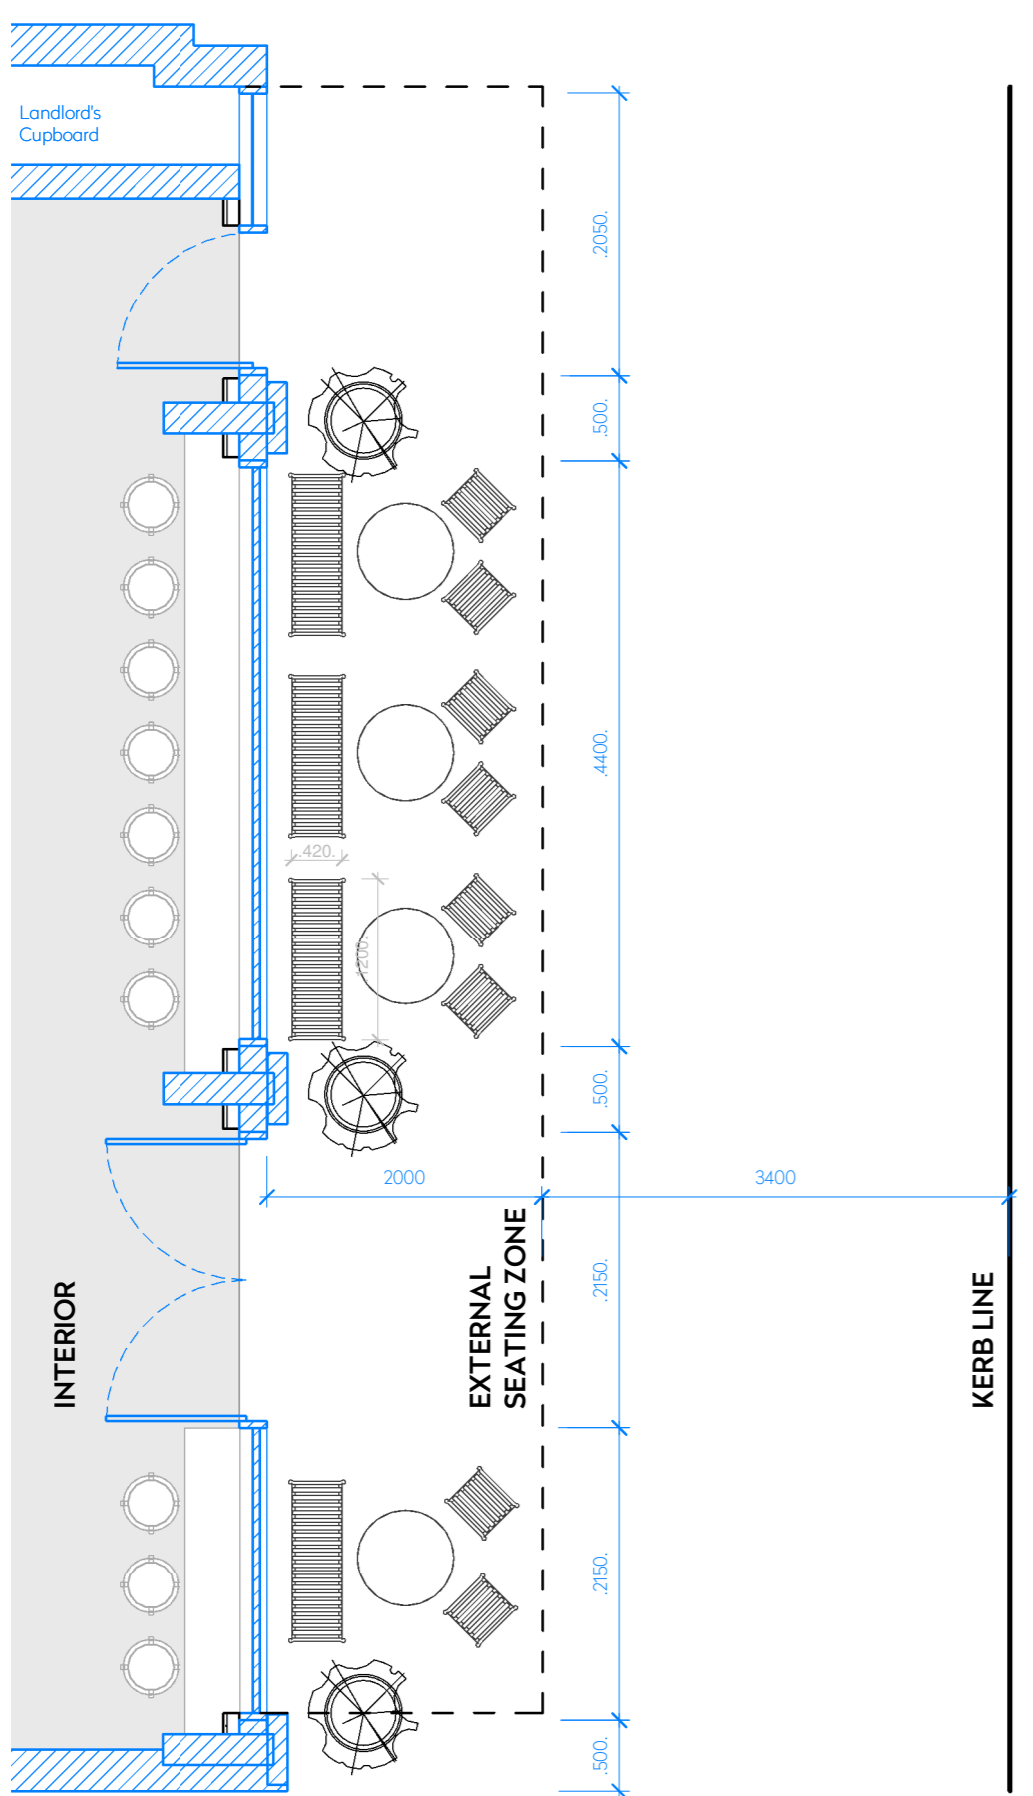

1 EXTERIOR PLAN
1:50

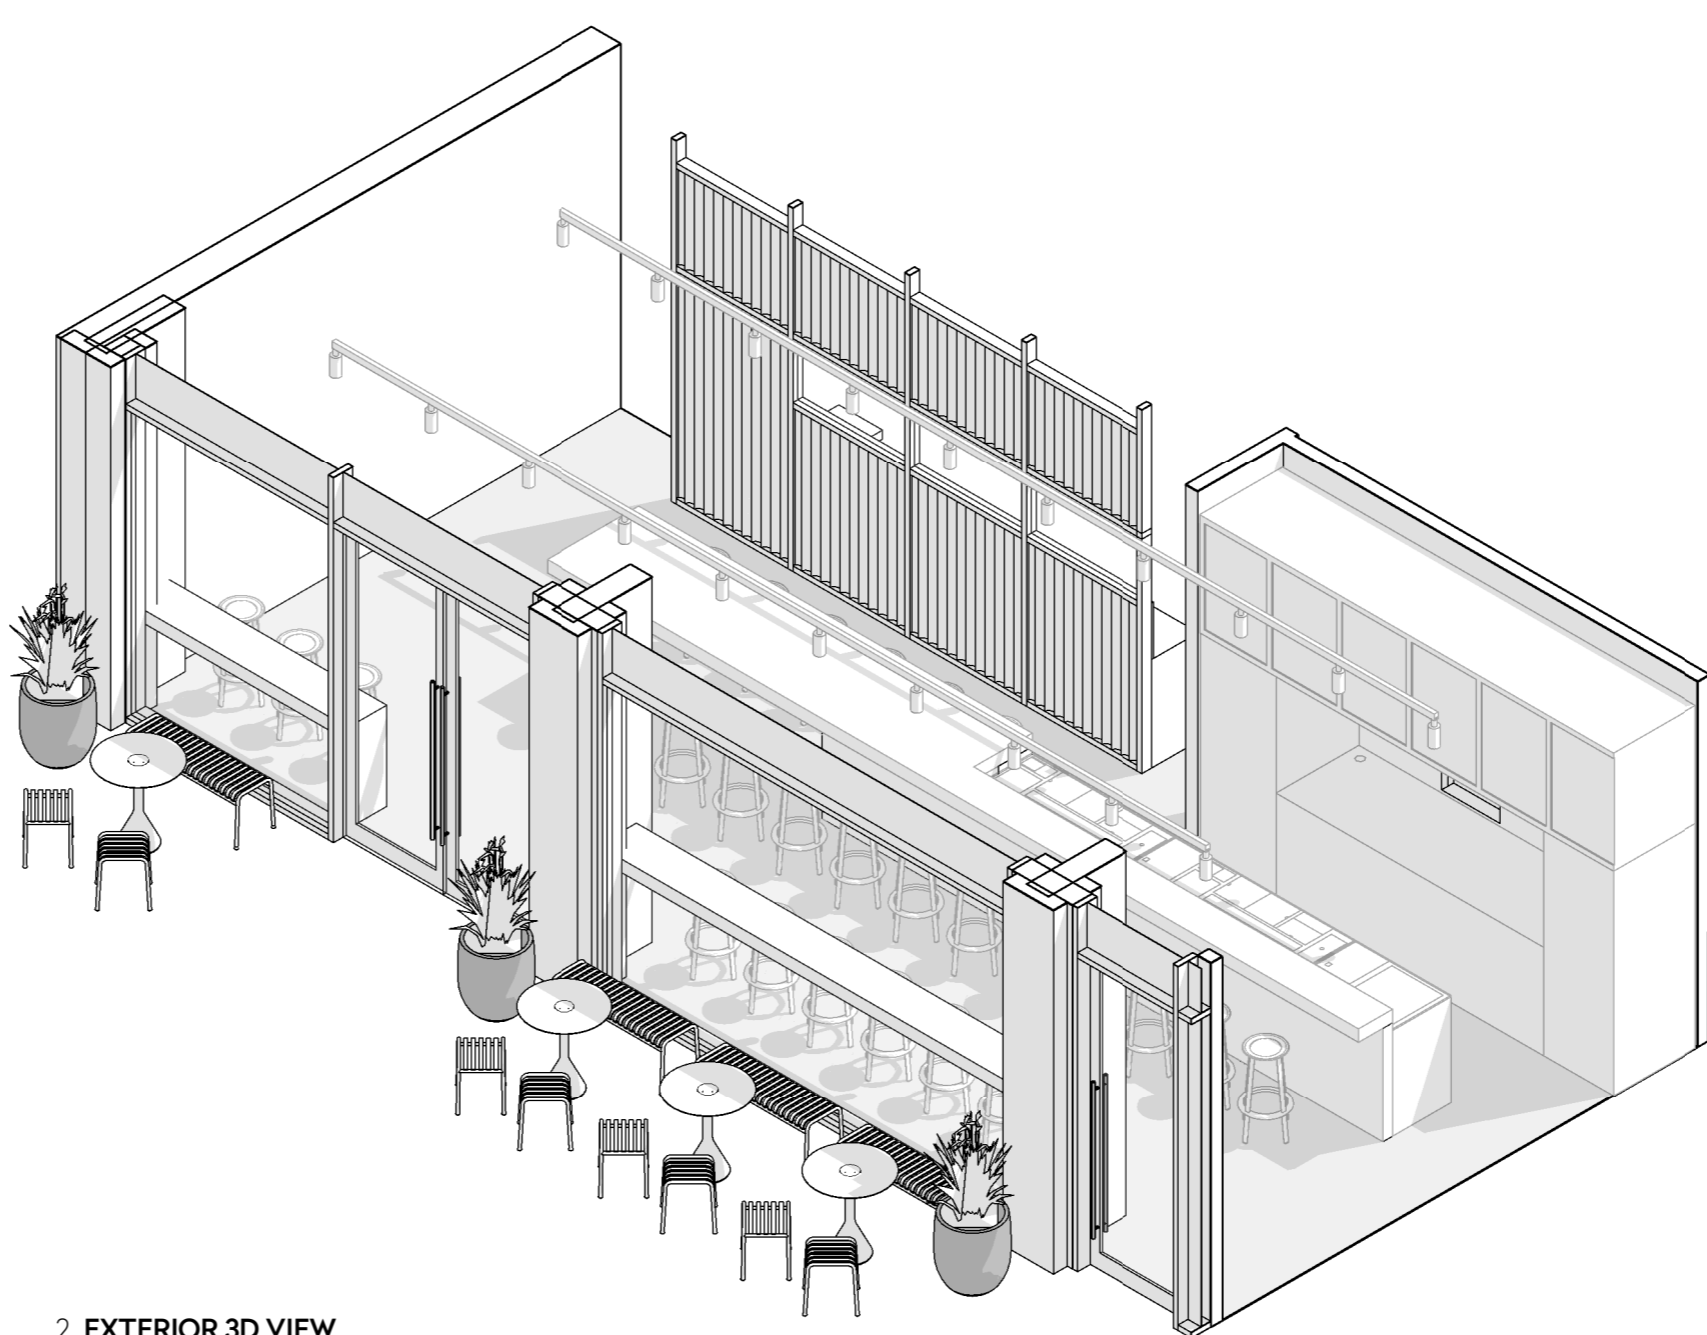

2 EXTERIOR 3D VIEW

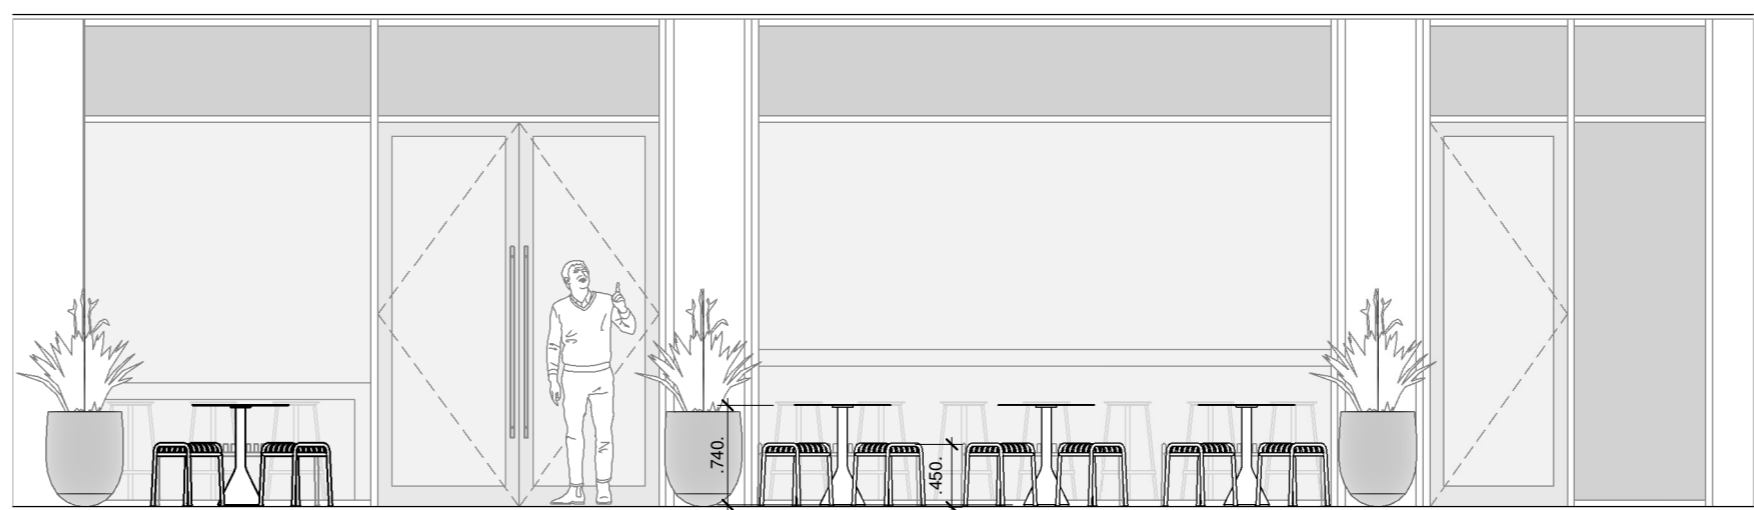

3 ELEVATION
1:50



HAY PALISSADE BENCH



HAY PALISSADE CONE TABLE



HAY PALISSADE STOOL

4 PROPOSED FURNITURE